



[Handwritten Signature]

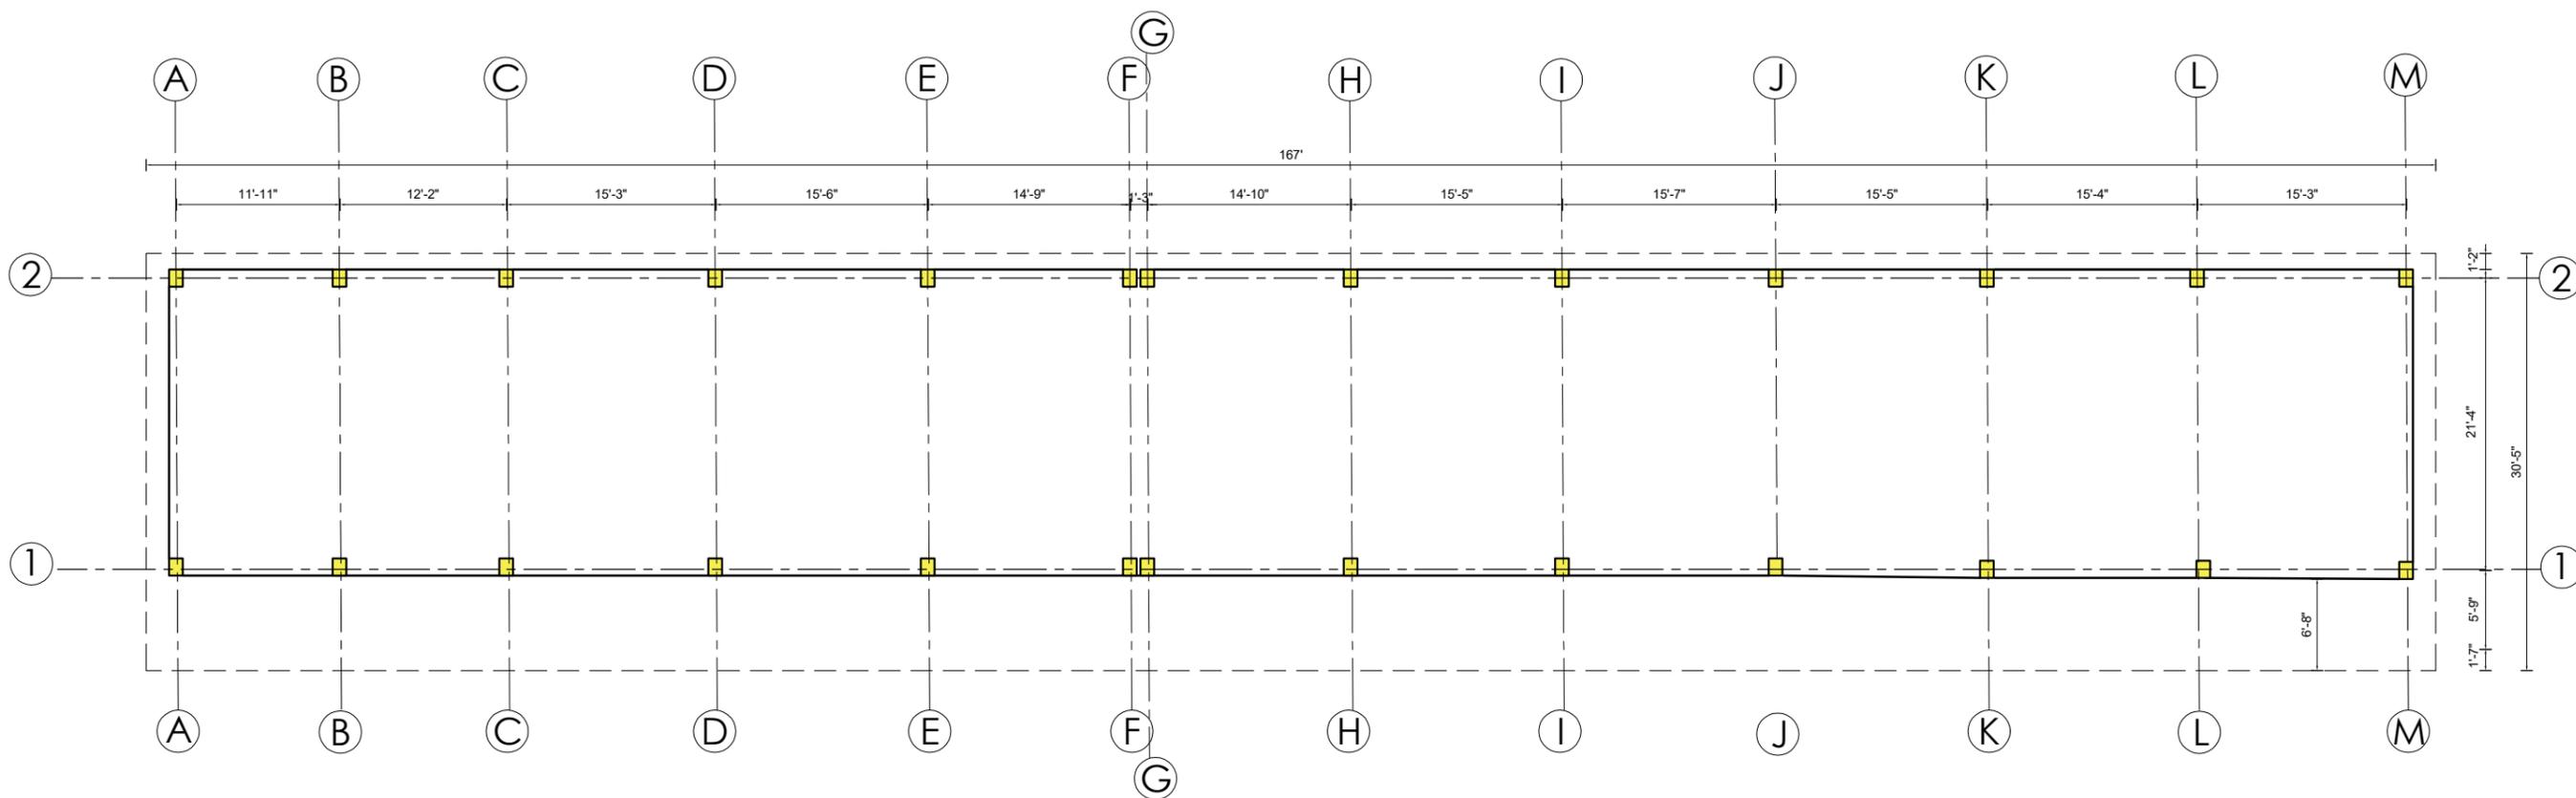




<p>INTERFACE ENGINEERING PVT.LTD Koteshwor, Kathmandu info.interfaceeng@gmail.com, 01-4544164</p>	<p>PROJECT: Consultancy Service for Construction of Additional one storey Extension with steel structure at KV, EOI, Kathmandu</p>	<p>CLIENT: Kendriya Vidyalaya Embassy of India Lazimpat, Kathmandu, Nepal</p>	<p>APPROVED BY: A. JERALD</p> <p>CHECKED BY:</p>	<p>DESIGNED BY : SURESH S. THINGH</p> <p>DRAWN BY : ROSHANI NAPIT</p>	<p>CONSULTANCY STAMP</p>	<p>SHEET TITLE : AS-BUILT PLAN</p> <p>DATE : JAN, 2026</p> <p>SCALE : 1:150</p>	<p>Sheet no :-</p> <p style="text-align: center; font-size: 2em; font-weight: bold;">1</p>
--	---	--	--	---	---------------------------------	--	---

ROAD

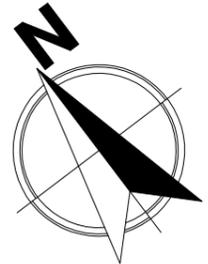

PEDESTRIAN PATHWAY

CLIMB ROOM

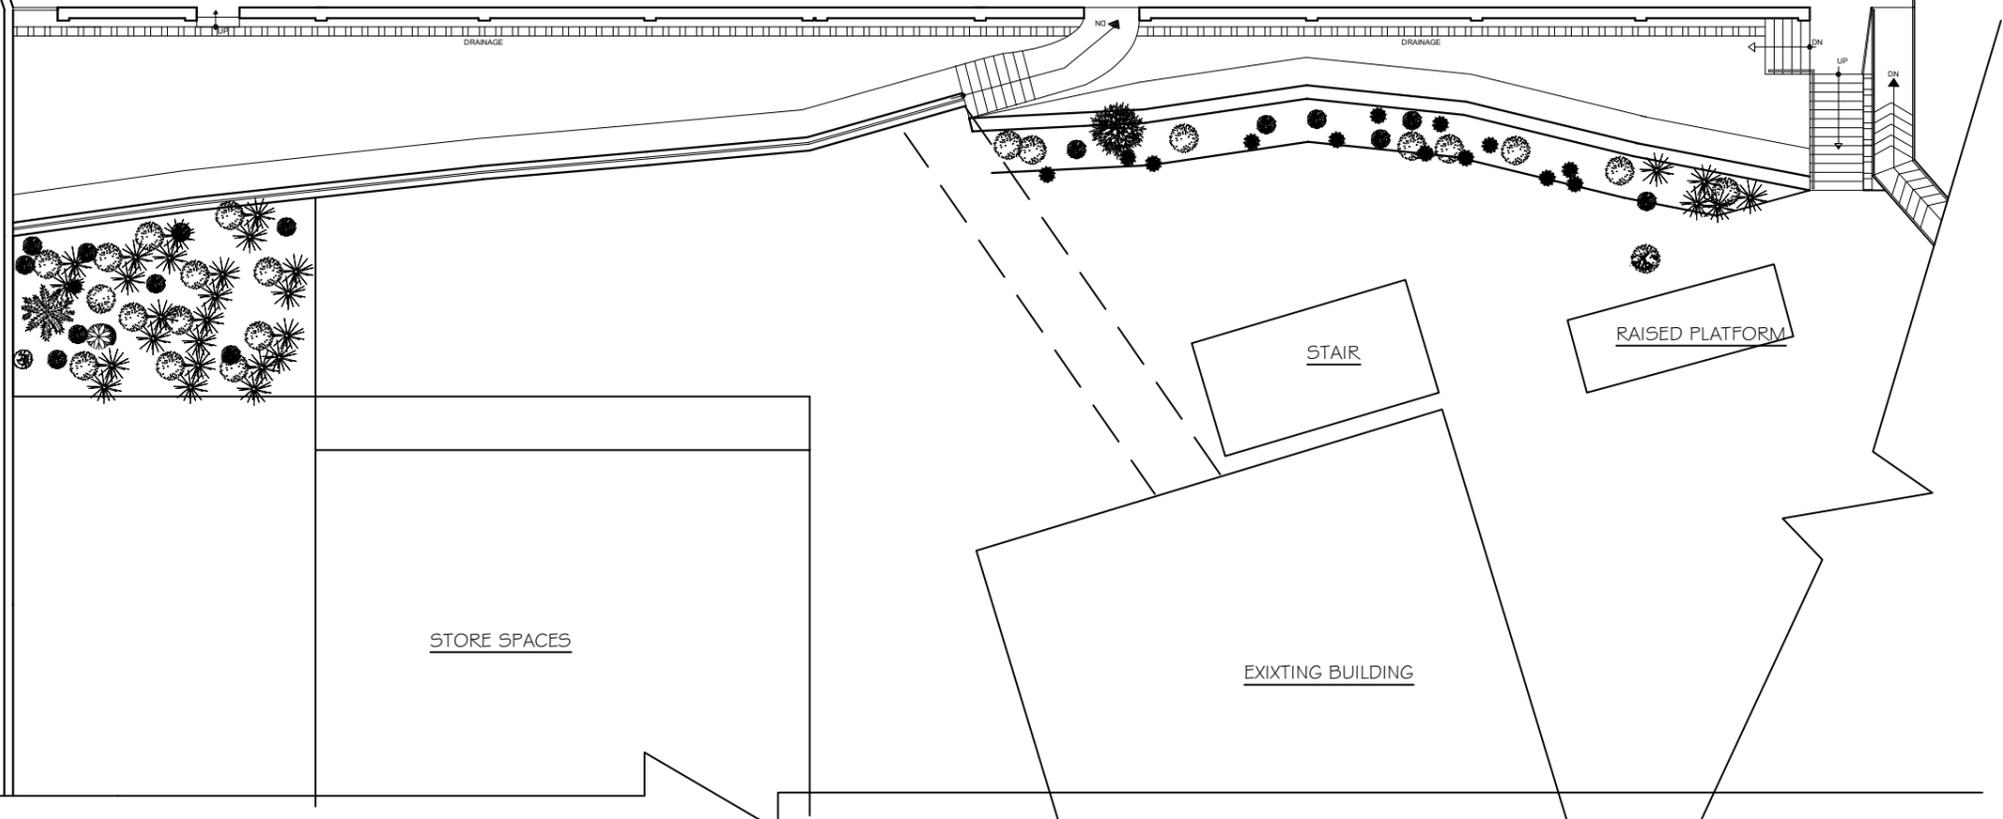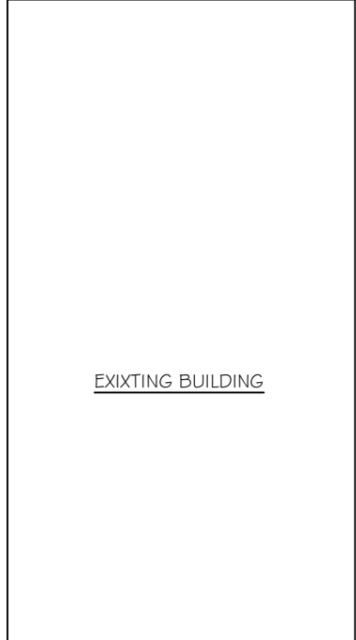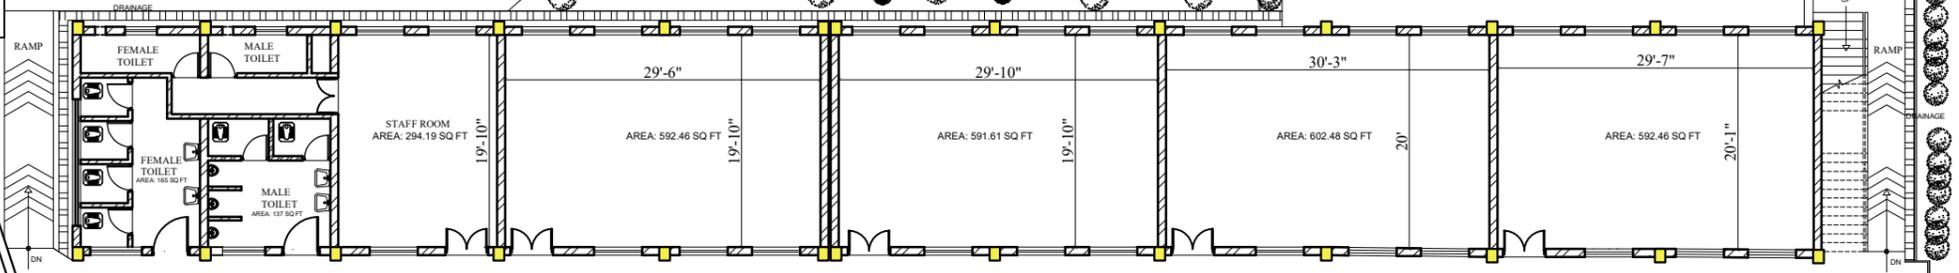

INTERFACE ENGINEERING PVT.LTD

Koteshwor, Kathmandu
info.interfaceeng@gmail.com, 01-4544164

PROJECT:
Consultancy Service for Construction of
Additional one storey Extension with steel
structure at KV, EOI, Kathmandu

CLIENT:
Kendriya Vidyalaya
Embassy of India
Lazimpat, Kathmandu, Nepal

APPROVED BY:
A. JERALD

CHECKED BY:

DESIGNED BY : SURESH S. THINGH

DRAWN BY : ROSHANI NAPIT

CONSULTANCY STAMP


SHEET TITLE :
SITE PLAN

DATE :JAN, 2026

SCALE : 1:200

Sheet no :-

2

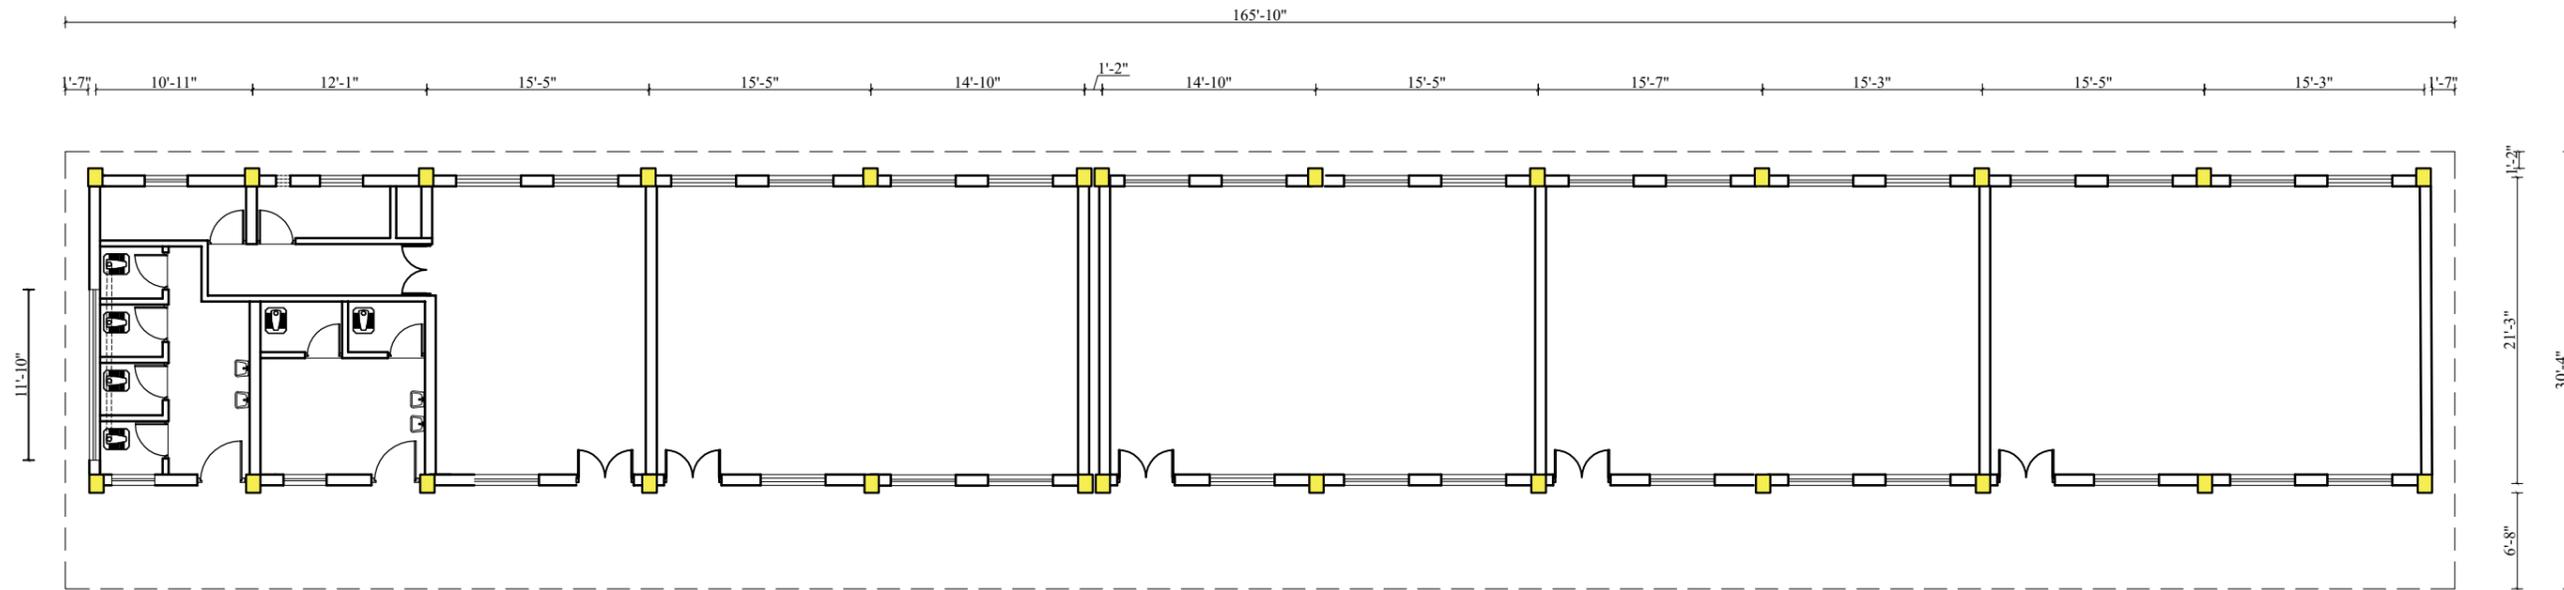

GROUND FLOOR PLAN AS-BUILT DRAWING

INTERFACE ENGINEERING PVT.LTD

Koteshwor, Kathmandu
info.interfaceeng@gmail.com, 01-4544164

PROJECT:

Consultancy Service for Construction of
Additional one storey Extension with steel
structure at KV, EOI, Kathmandu

CLIENT:

Kendriya Vidyalaya
Embassy of India
Lazimpat, Kathmandu, Nepal

APPROVED BY:
A. JERALD

CHECKED BY:

DESIGNED BY : SURESH S. THINGH

DRAWN BY : ROSHANI NAPIT

CONSULTANCY STAMP

SHEET TITLE :
GROUND FP



DATE : JAN, 2026

SCALE : 1:150

Sheet no :-



3

A. JERALD

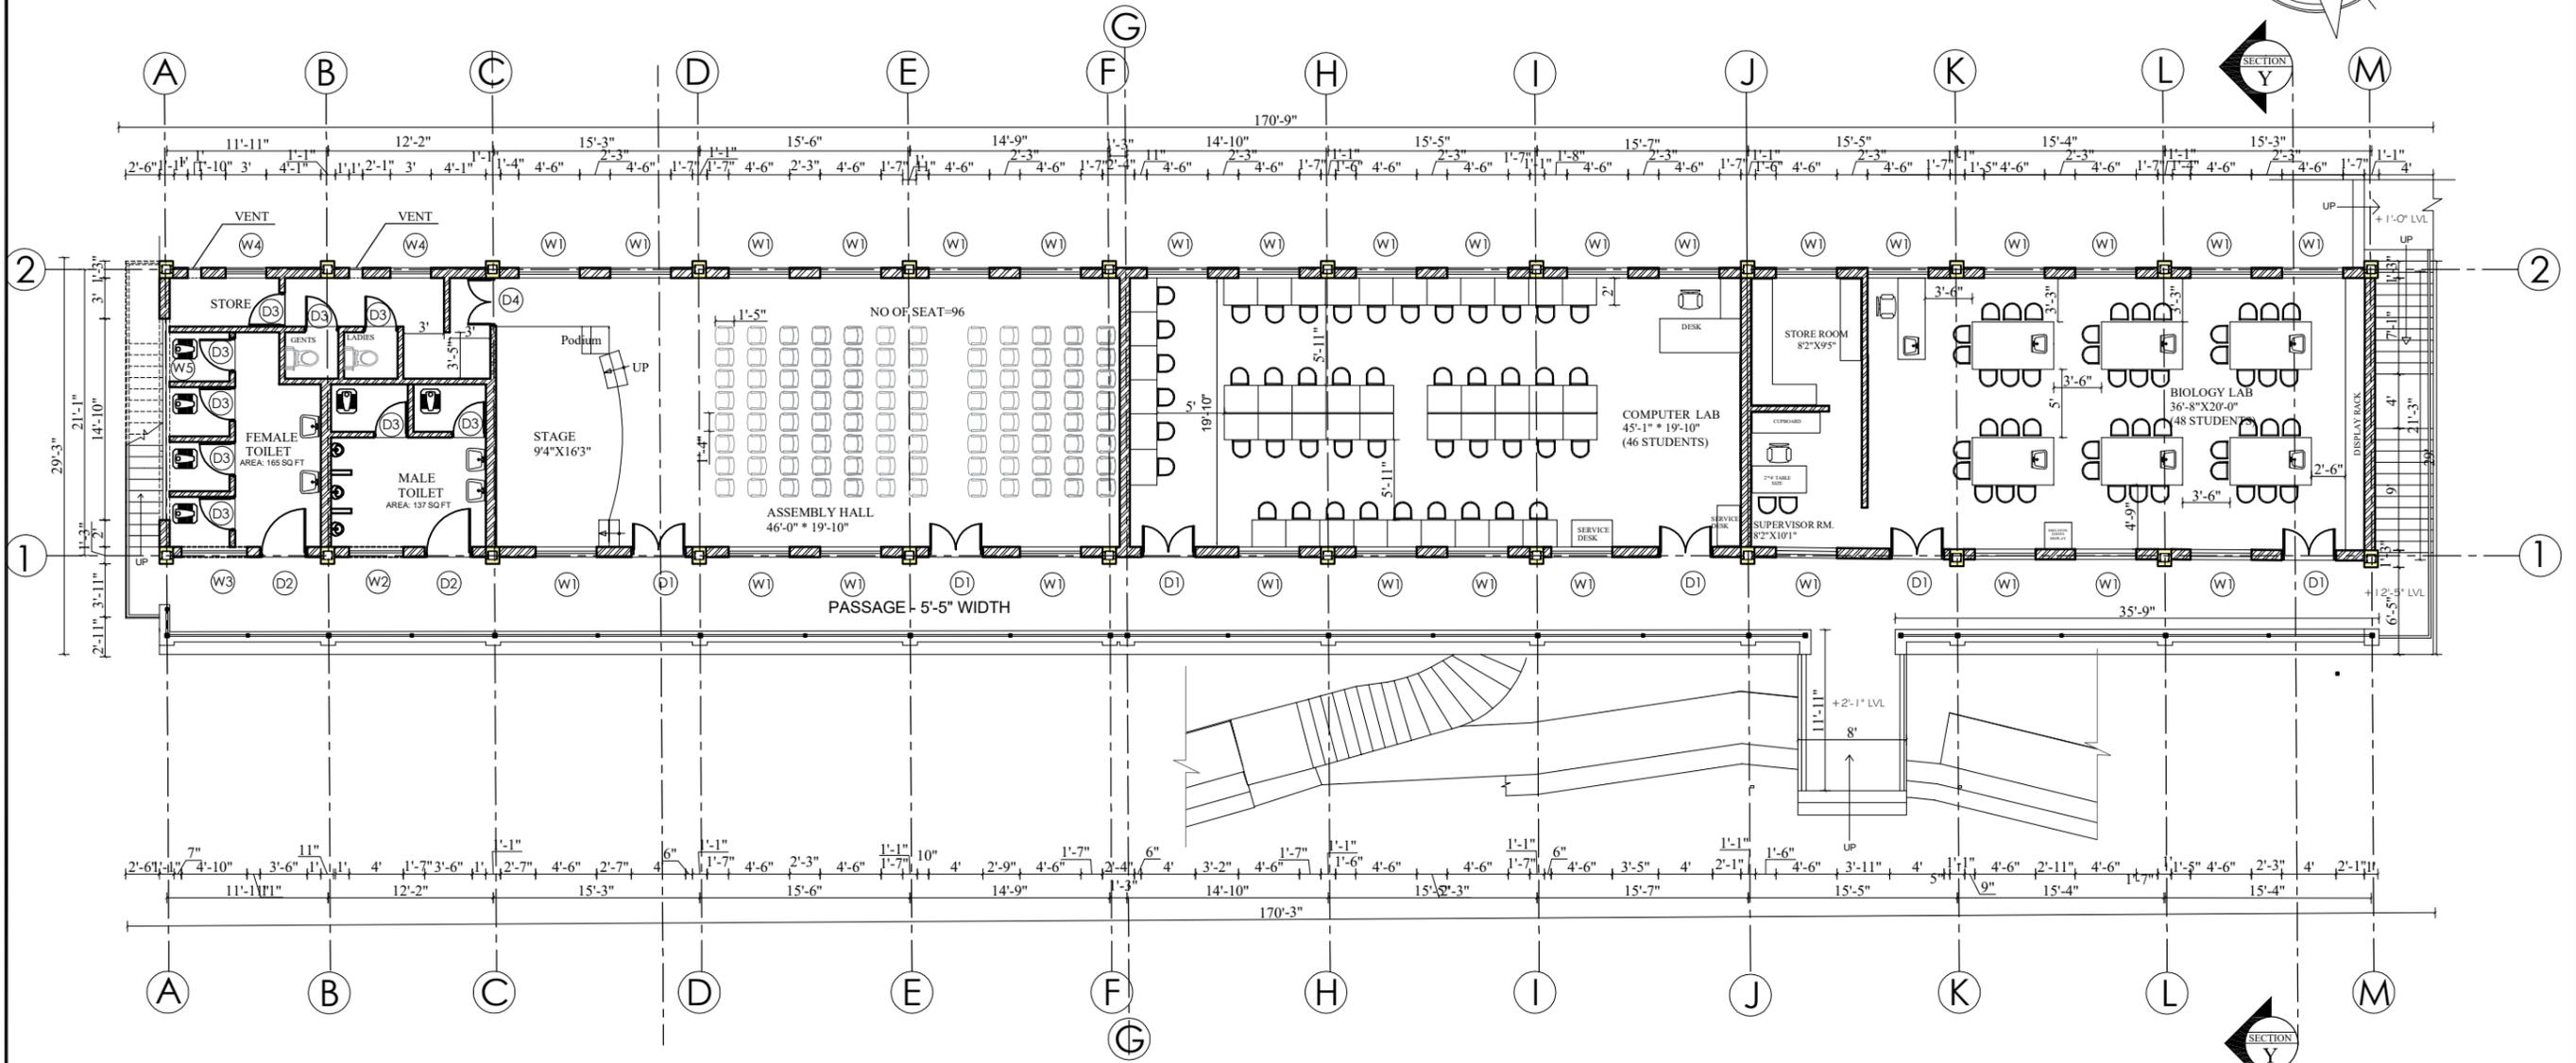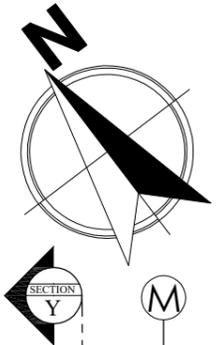

FIRST FLOOR PLAN
AREA: 3698.63 SQ.FT

<p>INTERFACE ENGINEERING PVT.LTD Koteshwor, Kathmandu info.interfaceeng@gmail.com, 01-4544164</p>	<p>PROJECT: Consultancy Service for Construction of Additional one storey Extension with steel structure at KV, EOI, Kathmandu</p>	<p>CLIENT: Kendriya Vidyalaya Embassy of India Lazimpat, Kathmandu, Nepal</p>	<p>APPROVED BY: A. JERALD</p> <p>CHECKED BY:</p>	<p>DESIGNED BY : SURESH S. THINGH</p> <p>DRAWN BY : ROSHANI NAPIT</p>	<p>CONSULTANCY STAMP</p>	<p>SHEET TITLE : FIRST FP</p> <p>DATE :JAN, 2026</p> <p>SCALE : 1:150</p>	<p>Sheet no :- 4</p>
--	--	---	--	---	--------------------------	---	---------------------------------

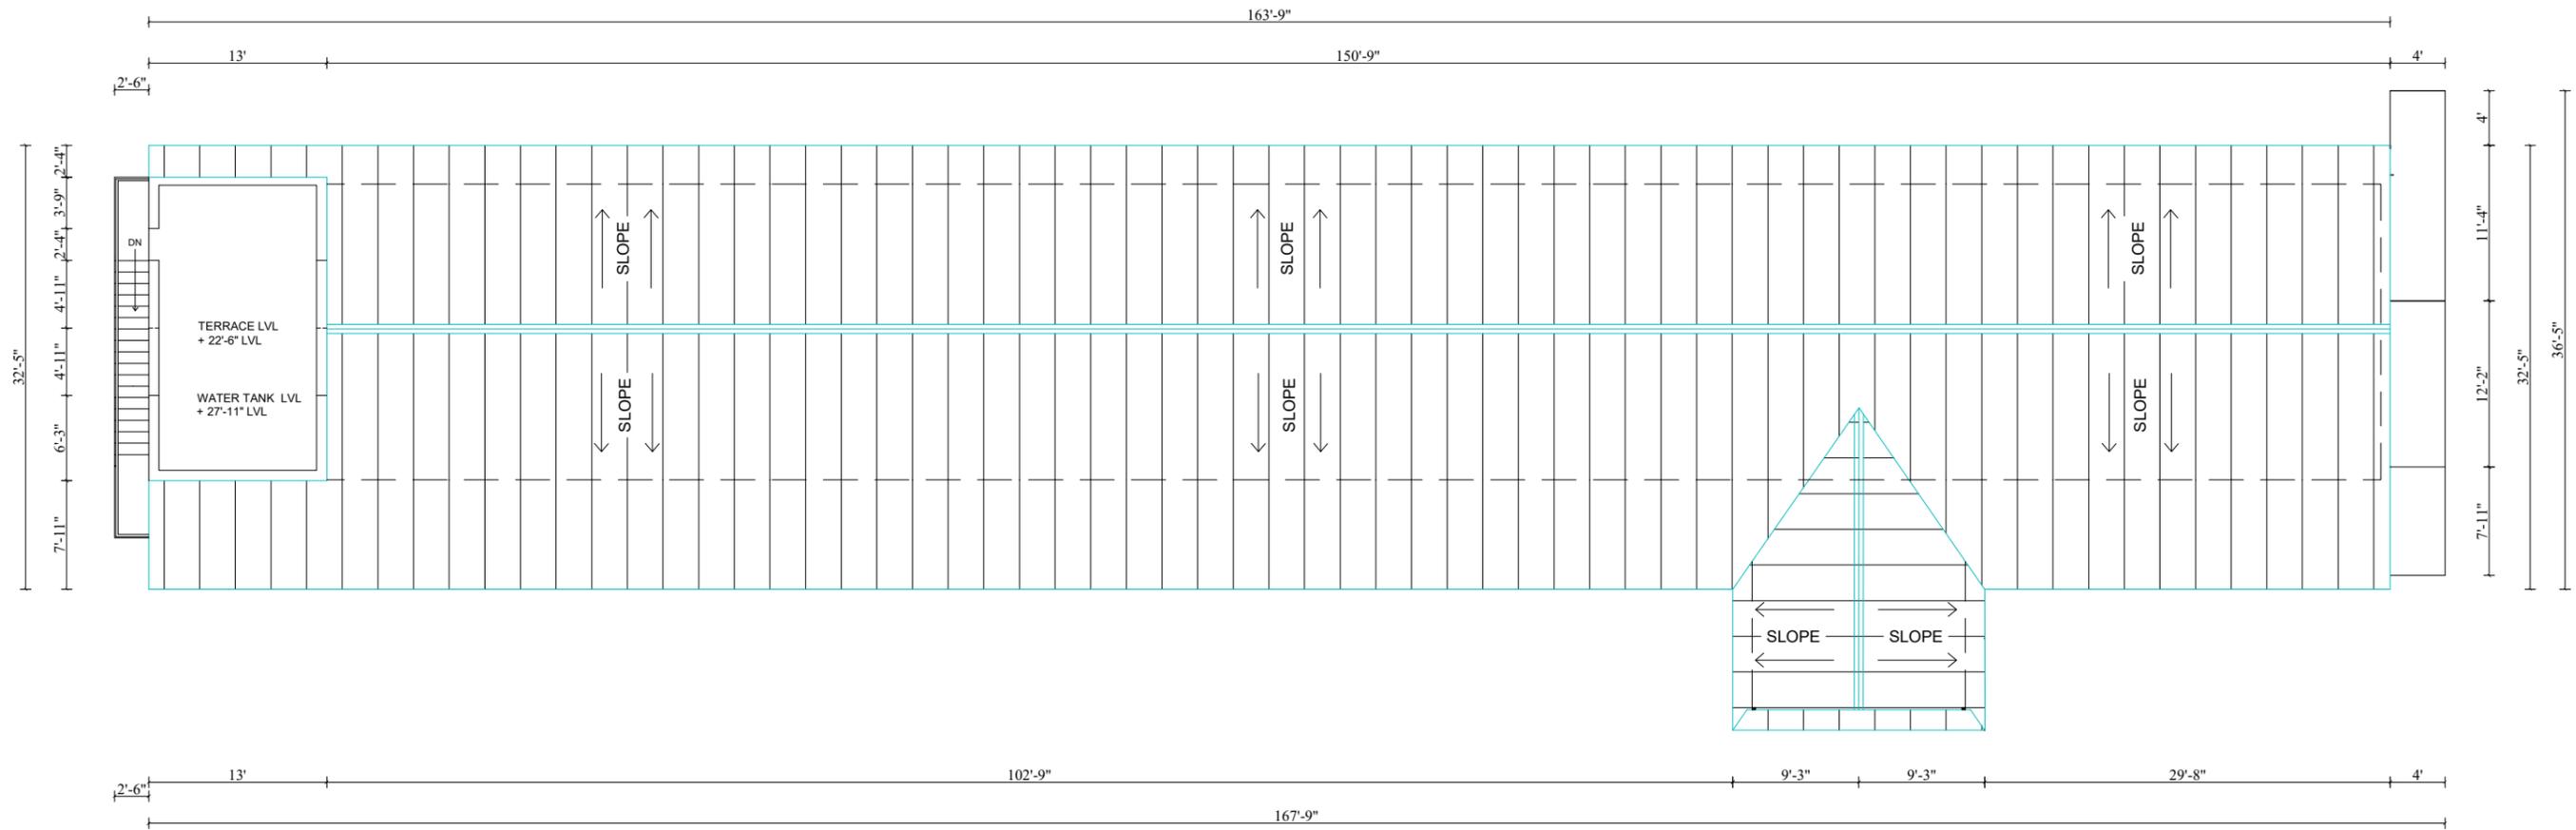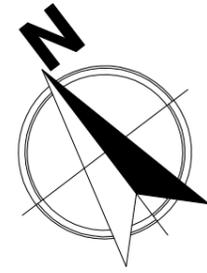


ROOF PLAN

<p>INTERFACE ENGINEERING PVT.LTD Koteshwor, Kathmandu info.interfaceeng@gmail.com, 01-4544164</p>	<p>PROJECT: Consultancy Service for Construction of Additional one storey Extension with steel structure at KV, EOI, Kathmandu</p>	<p>CLIENT: Kendriya Vidyalaya Embassy of India Lazimpat, Kathmandu, Nepal</p>	<p>APPROVED BY: A. JERALD</p> <p>CHECKED BY:</p>	<p>DESIGNED BY : SURESH S. THINGH</p> <p>DRAWN BY : ROSHANI NAPIT</p>	<p>CONSULTANCY STAMP</p>	<p>SHEET TITLE : ROOF PLAN</p> <p>DATE : JAN, 2026</p> <p>SCALE : 1:150</p>	<p>Sheet no :- 5</p>
--	---	--	--	---	---------------------------------	--	--

Handwritten signature



SOUTH ELEVATION

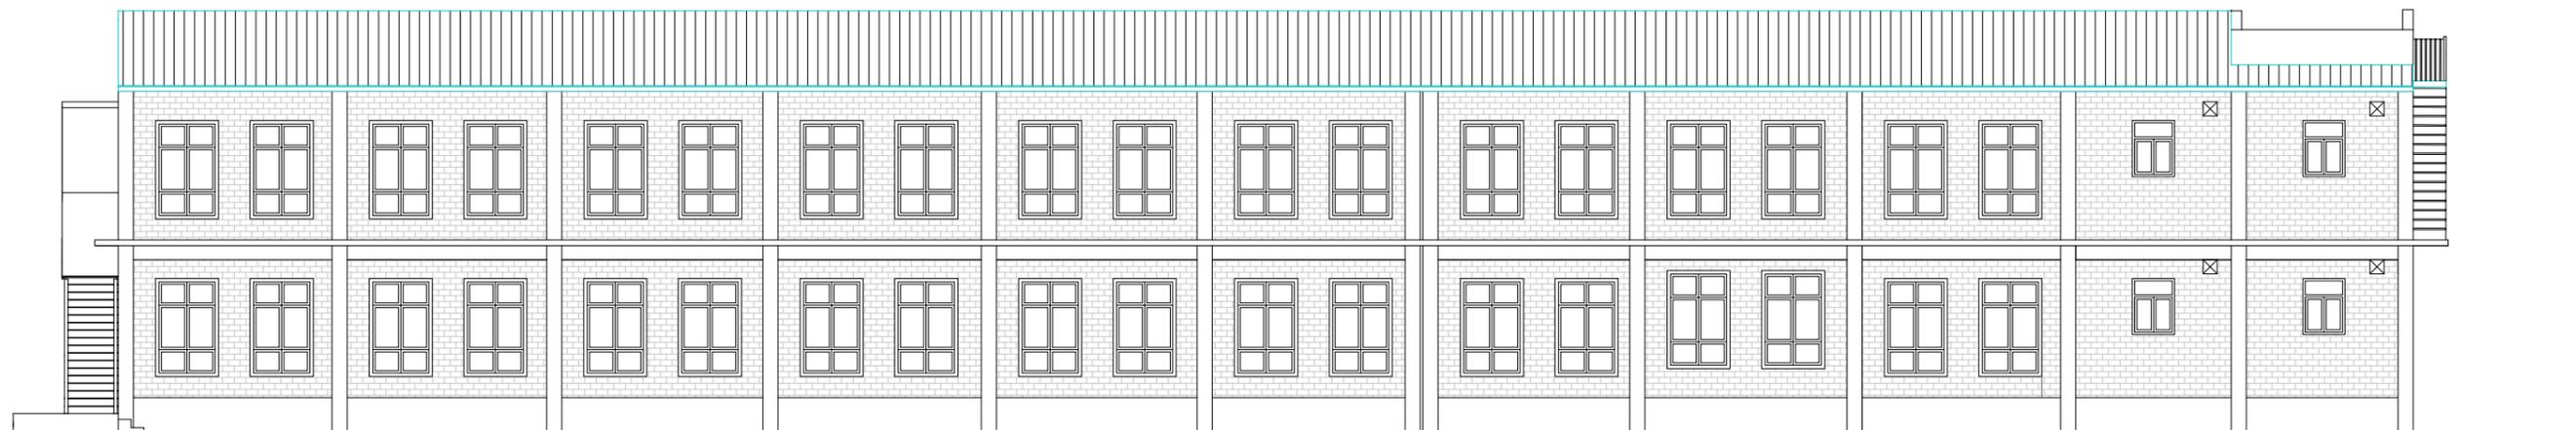

NORTH ELEVATION

INTERFACE ENGINEERING PVT.LTD

Koteshwor, Kathmandu
info.interfaceeng@gmail.com, 01-4544164

PROJECT:

Consultancy Service for Construction of
Additional one storey Extension with steel
structure at KV, EOI, Kathmandu

CLIENT:

Kendriya Vidyalaya
Embassy of India
Lazimpat, Kathmandu, Nepal

APPROVED BY:
A. JERALD

CHECKED BY:

DESIGNED BY : SURESH S. THINGH

DRAWN BY : ROSHANI NAPIT

CONSULTANCY STAMP

SHEET TITLE :
ELEVATIONS


DATE :JAN, 2026

SCALE : 1:150

Sheet no :-

6

Handwritten signature

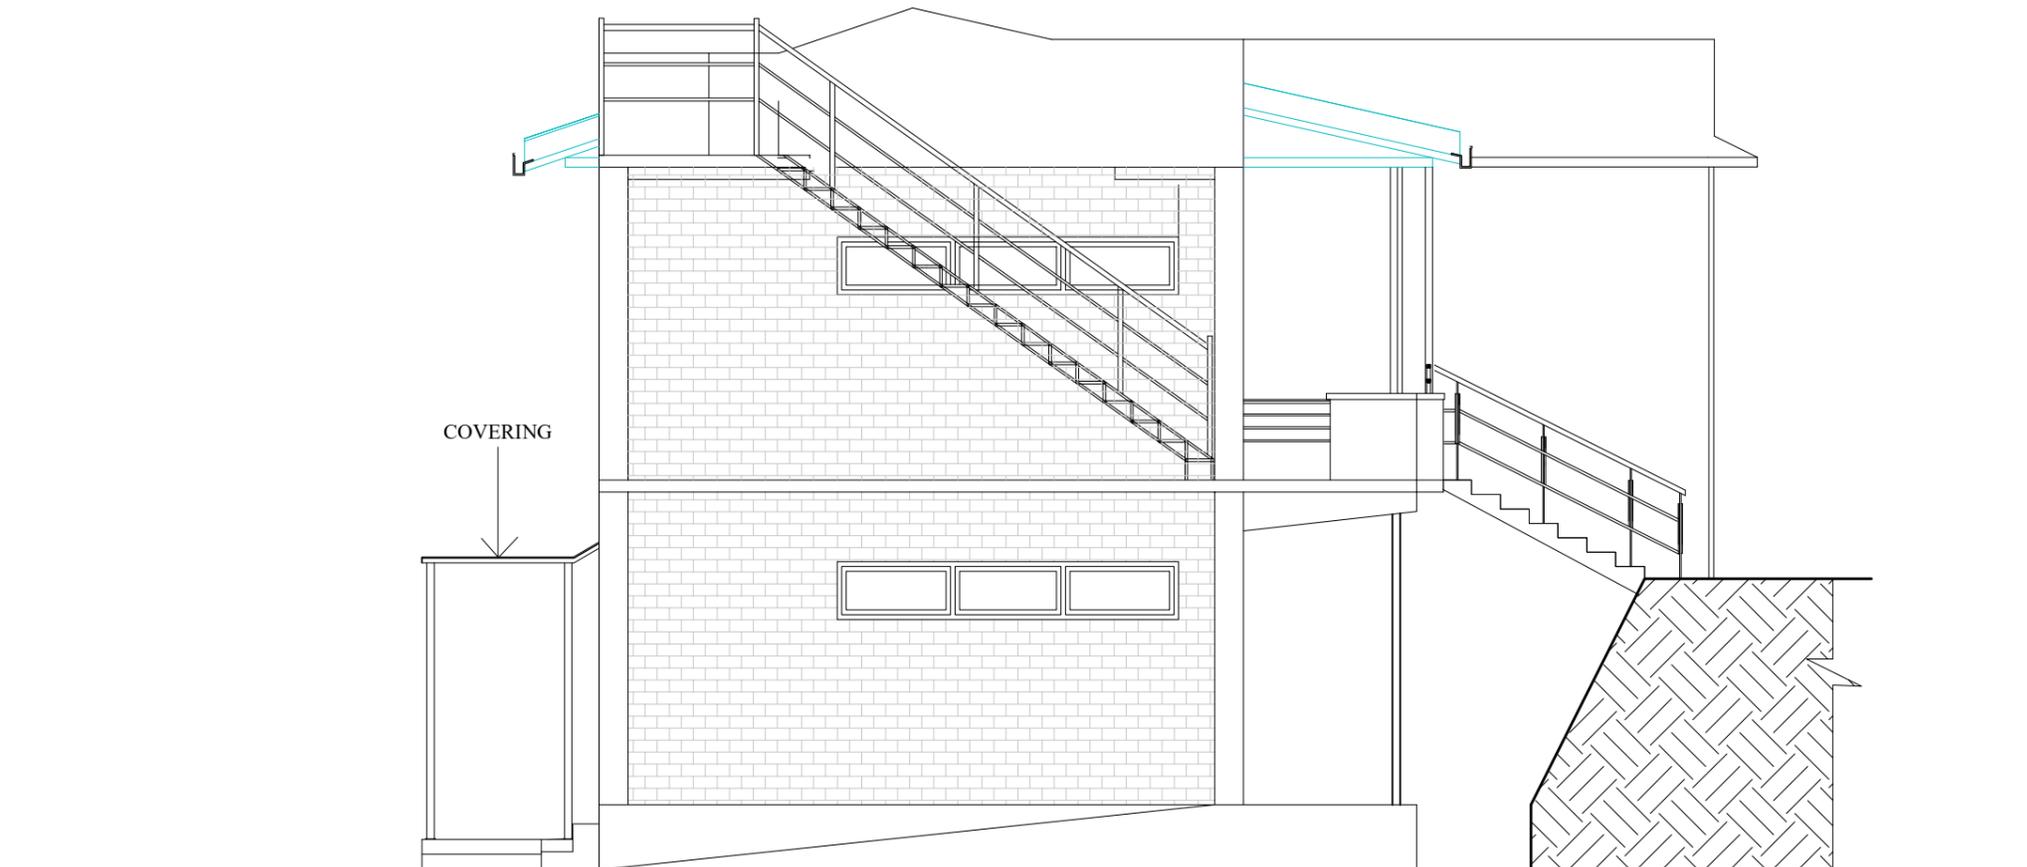

WEST ELEVATION

INTERFACE ENGINEERING PVT.LTD

Koteshwor, Kathmandu
info.interfaceeng@gmail.com, 01-4544164

PROJECT:

Consultancy Service for Construction of
Additional one storey Extension with steel
structure at KV, EOI, Kathmandu

CLIENT:

Kendriya Vidyalaya
Embassy of India
Lazimpat, Kathmandu, Nepal

APPROVED BY:

A. JERALD

CHECKED BY:

DESIGNED BY : SURESH S. THINGH

DRAWN BY : ROSHANI NAPIT

CONSULTANCY STAMP

SHEET TITLE :

WEST ELEVATION


DATE :JAN, 2026

SCALE : 1:75

Sheet no :-

7

Handwritten signature

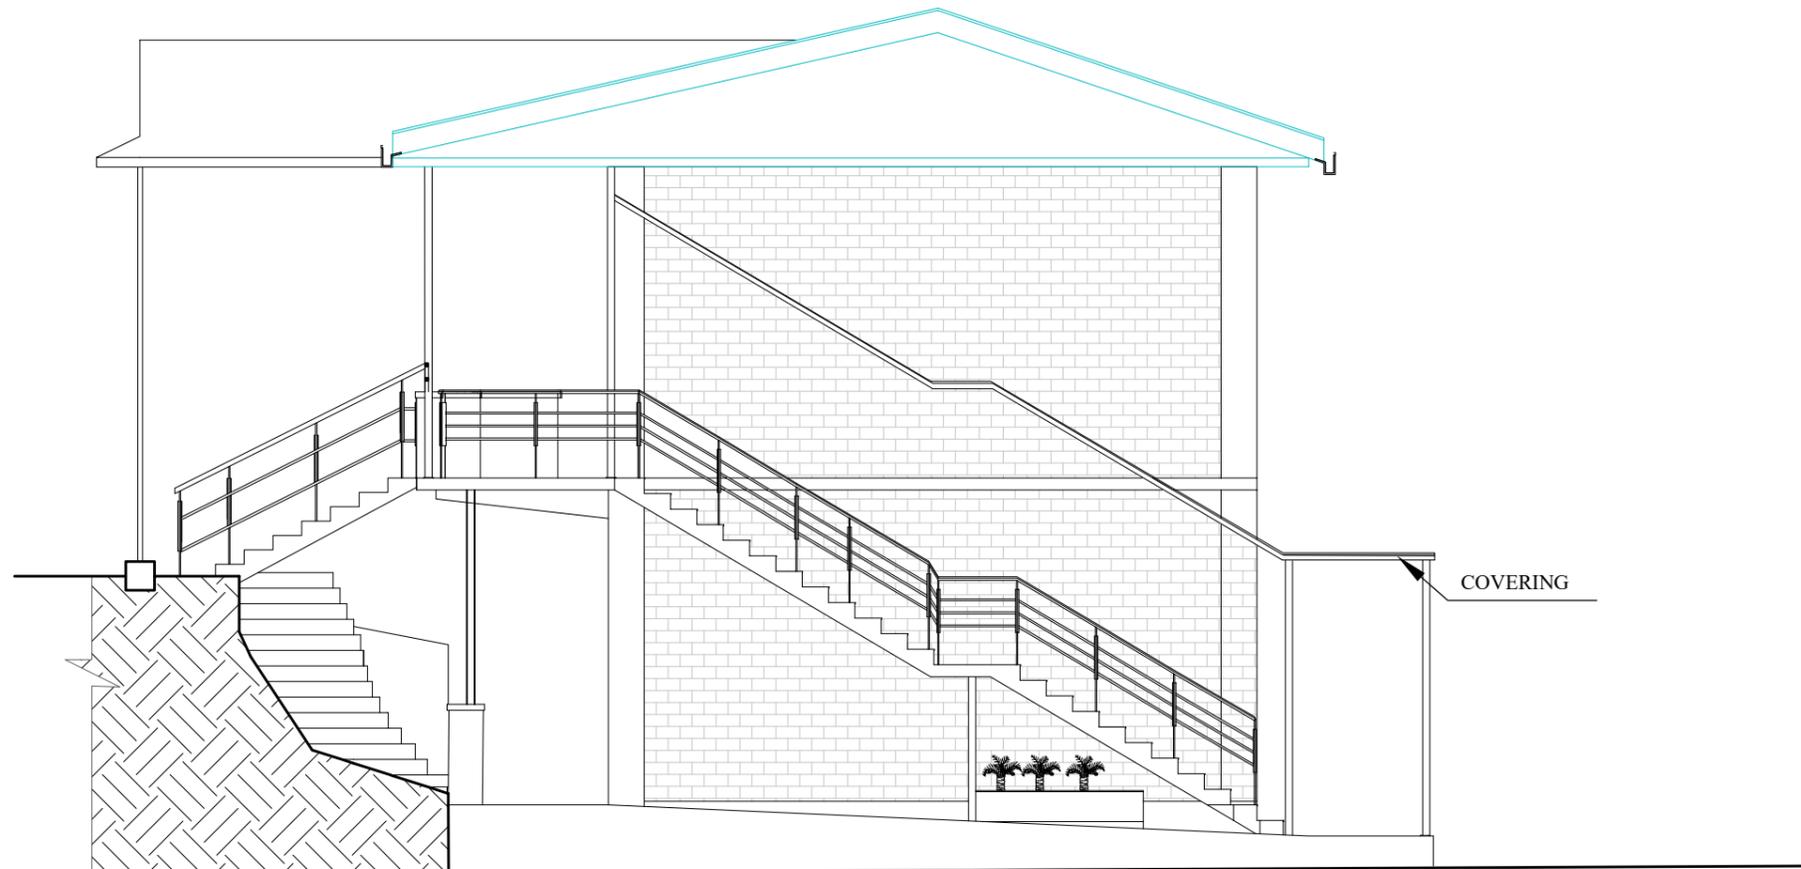

EAST ELEVATION

INTERFACE ENGINEERING PVT.LTD

Koteshwor, Kathmandu
info.interfaceeng@gmail.com, 01-4544164

PROJECT:
Consultancy Service for Construction of
Additional one storey Extension with steel
structure at KV, EOI, Kathmandu

CLIENT:
Kendriya Vidyalaya
Embassy of India
Lazimpat, Kathmandu, Nepal

APPROVED BY:
A. JERALD

CHECKED BY:

DESIGNED BY : SURESH S. THINGH

DRAWN BY : ROSHANI NAPIT

CONSULTANCY STAMP

SHEET TITLE :
EAST ELEVATION


DATE :JAN, 2026

SCALE : 1:75

Sheet no :-

8


[Handwritten Signature]

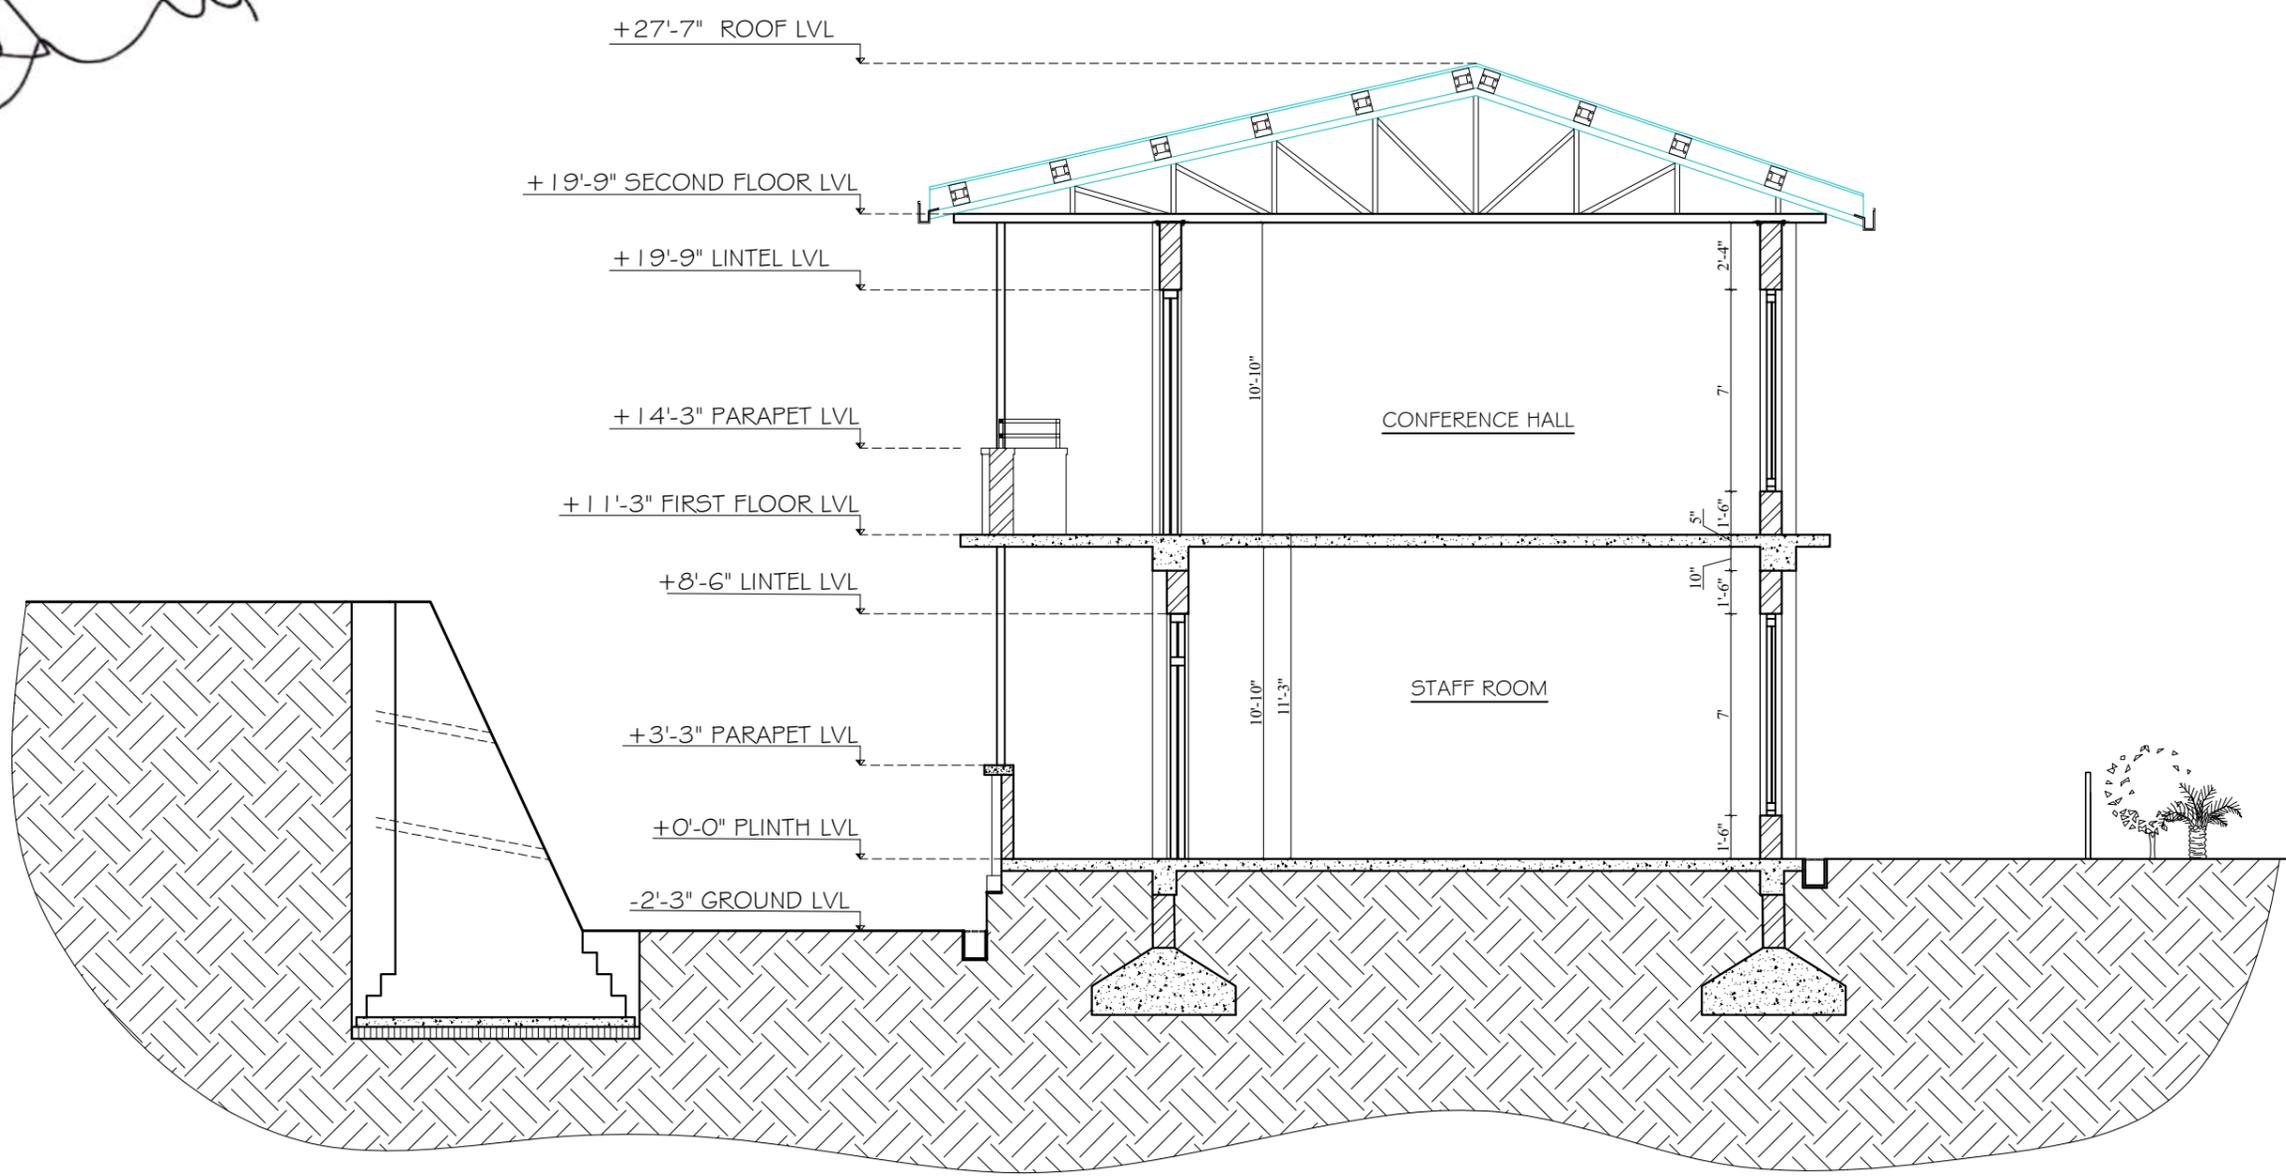

SECTION AT X-X

<p>INTERFACE ENGINEERING PVT.LTD Koteshwor, Kathmandu info.interfaceeng@gmail.com, 01-4544164</p>	<p>PROJECT: Consultancy Service for Construction of Additional one storey Extension with steel structure at KV, EOI, Kathmandu</p>	<p>CLIENT: Kendriya Vidyalaya Embassy of India Lazimpat, Kathmandu, Nepal</p>	<p>APPROVED BY: A. JERALD</p> <p>CHECKED BY:</p>	<p>DESIGNED BY: SURESH S. THINGH</p> <p>DRAWN BY: ROSHANI NAPIT</p>	<p>CONSULTANCY STAMP</p>	<p>SHEET TITLE : SECTION AT X-X</p> <p>DATE : JAN, 2026</p> <p>SCALE : 1:50</p>	<p>Sheet no :-</p> <p style="font-size: 2em; text-align: center;">9</p>
--	---	--	--	---	---------------------------------	--	---




[Handwritten Signature]

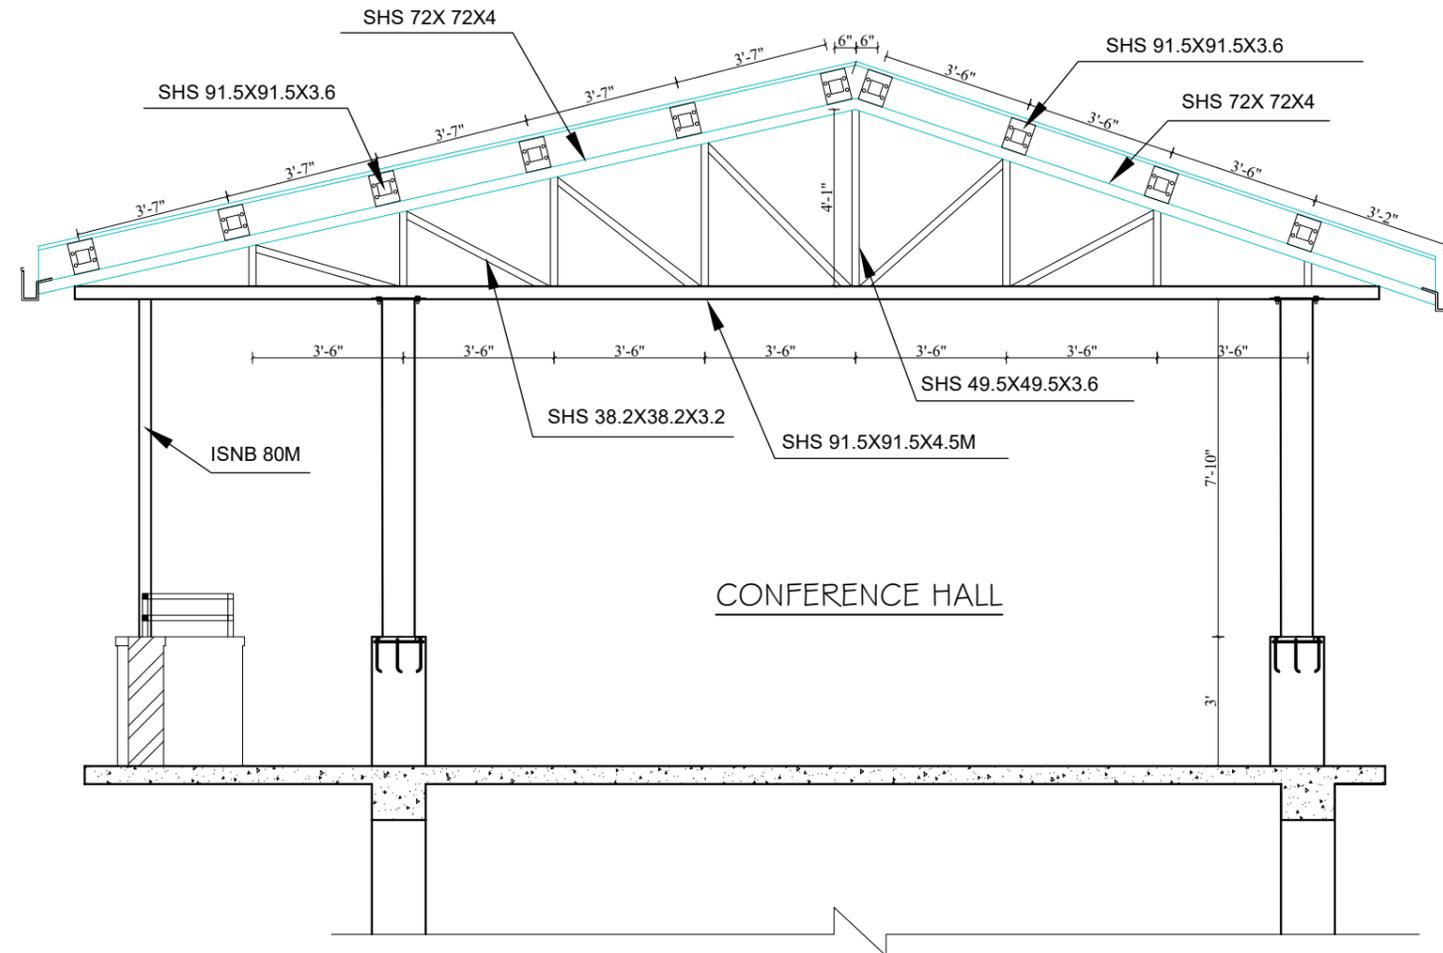

CONFERENCE HALL


TRUSS DETAILS

<p>INTERFACE ENGINEERING PVT.LTD Koteshwor, Kathmandu info.interfaceeng@gmail.com, 01-4544164</p>	<p>PROJECT: Consultancy Service for Construction of Additional one storey Extension with steel structure at KV, EOI, Kathmandu</p>	<p>CLIENT: Kendriya Vidyalaya Embassy of India Lazimpat, Kathmandu, Nepal</p>	<p>APPROVED BY: A. JERALD</p> <hr/> <p>CHECKED BY:</p>	<p>DESIGNED BY : SURESH S. THINGH</p> <hr/> <p>DRAWN BY : ROSHANI NAPIT</p>	<p>CONSULTANCY STAMP</p>	<p>SHEET TITLE : TRUSS DETAILS</p> <p>DATE :JAN, 2026</p> <p>SCALE : 1:50</p>	<p>Sheet no :-</p> <p style="font-size: 2em; text-align: center;">10</p>
--	--	---	--	---	--------------------------	--	---

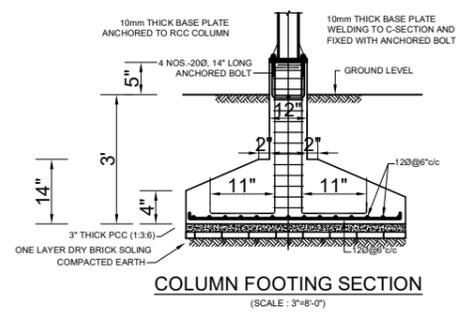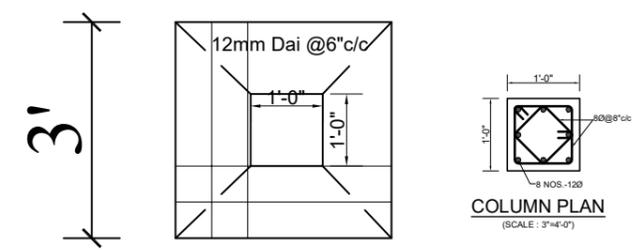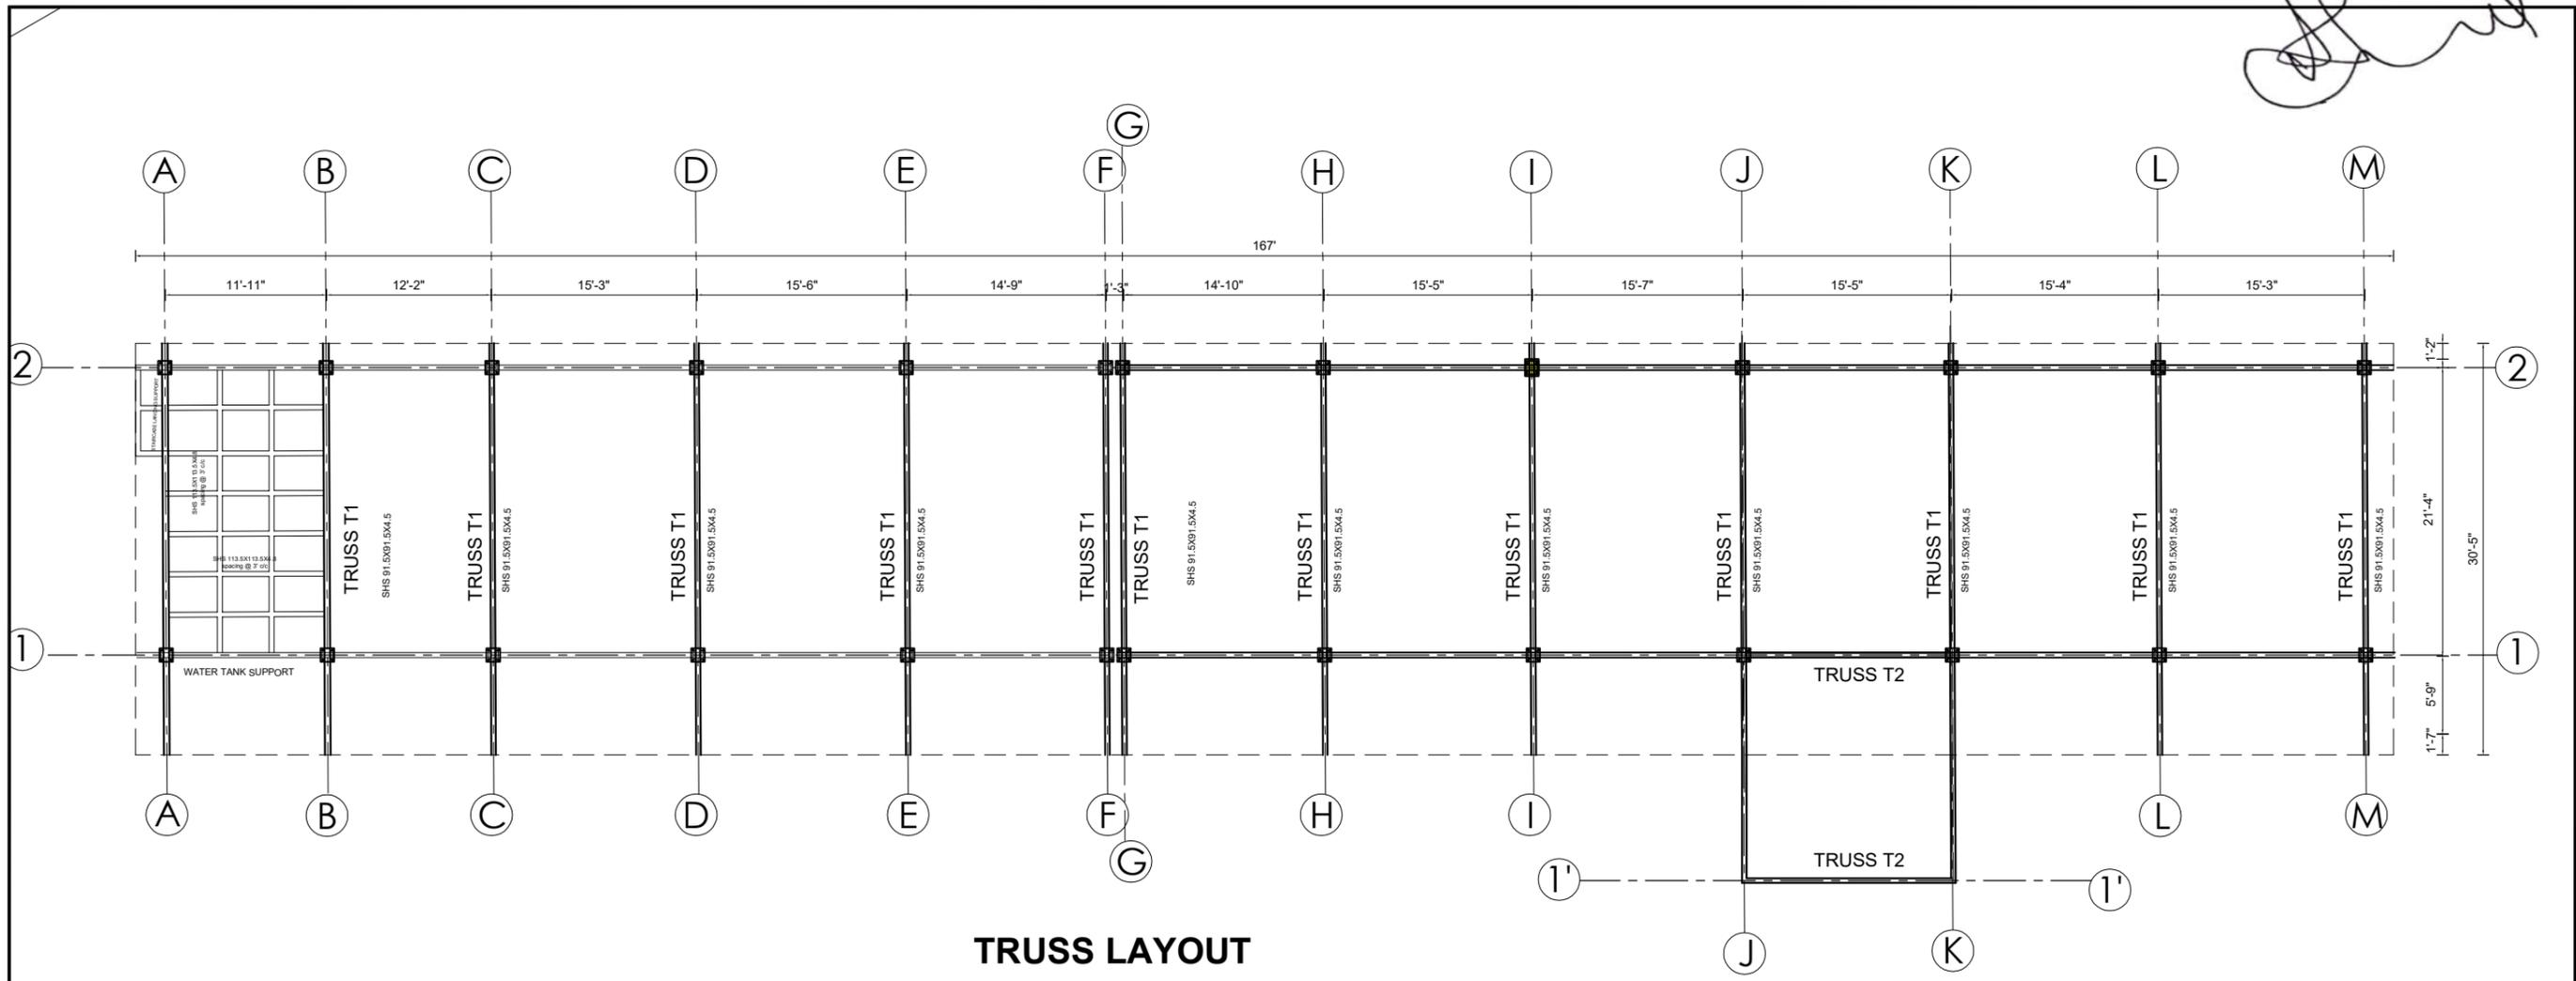

<p>INTERFACE ENGINEERING PVT.LTD Koteshwor, Kathmandu info.interfacceng@gmail.com, 01-4544164</p>	<p>PROJECT: Consultancy Service for Construction of Additional one storey Extension with steel structure at KV, EOI, Kathmandu</p>	<p>CLIENT: Kendriya Vidyalaya Embassy of India Lazimpat, Kathmandu, Nepal</p>	<p>APPROVED BY: A. JERALD</p> <p>CHECKED BY:</p>	<p>DESIGNED BY : UMESH THAPA</p> <p>DRAWN BY : ABDUL HAI MIYA</p>	<p>CONSULTANCY STAMP</p>	<p>SHEET TITLE : TRUSS DETAILS</p> <p>DATE : DEC, 2025</p> <p>SCALE : 1:150</p>	<p>Sheet no :-</p> <p style="font-size: 2em; text-align: center;">1</p>
--	---	--	--	---	---------------------------------	--	---


Handwritten signature

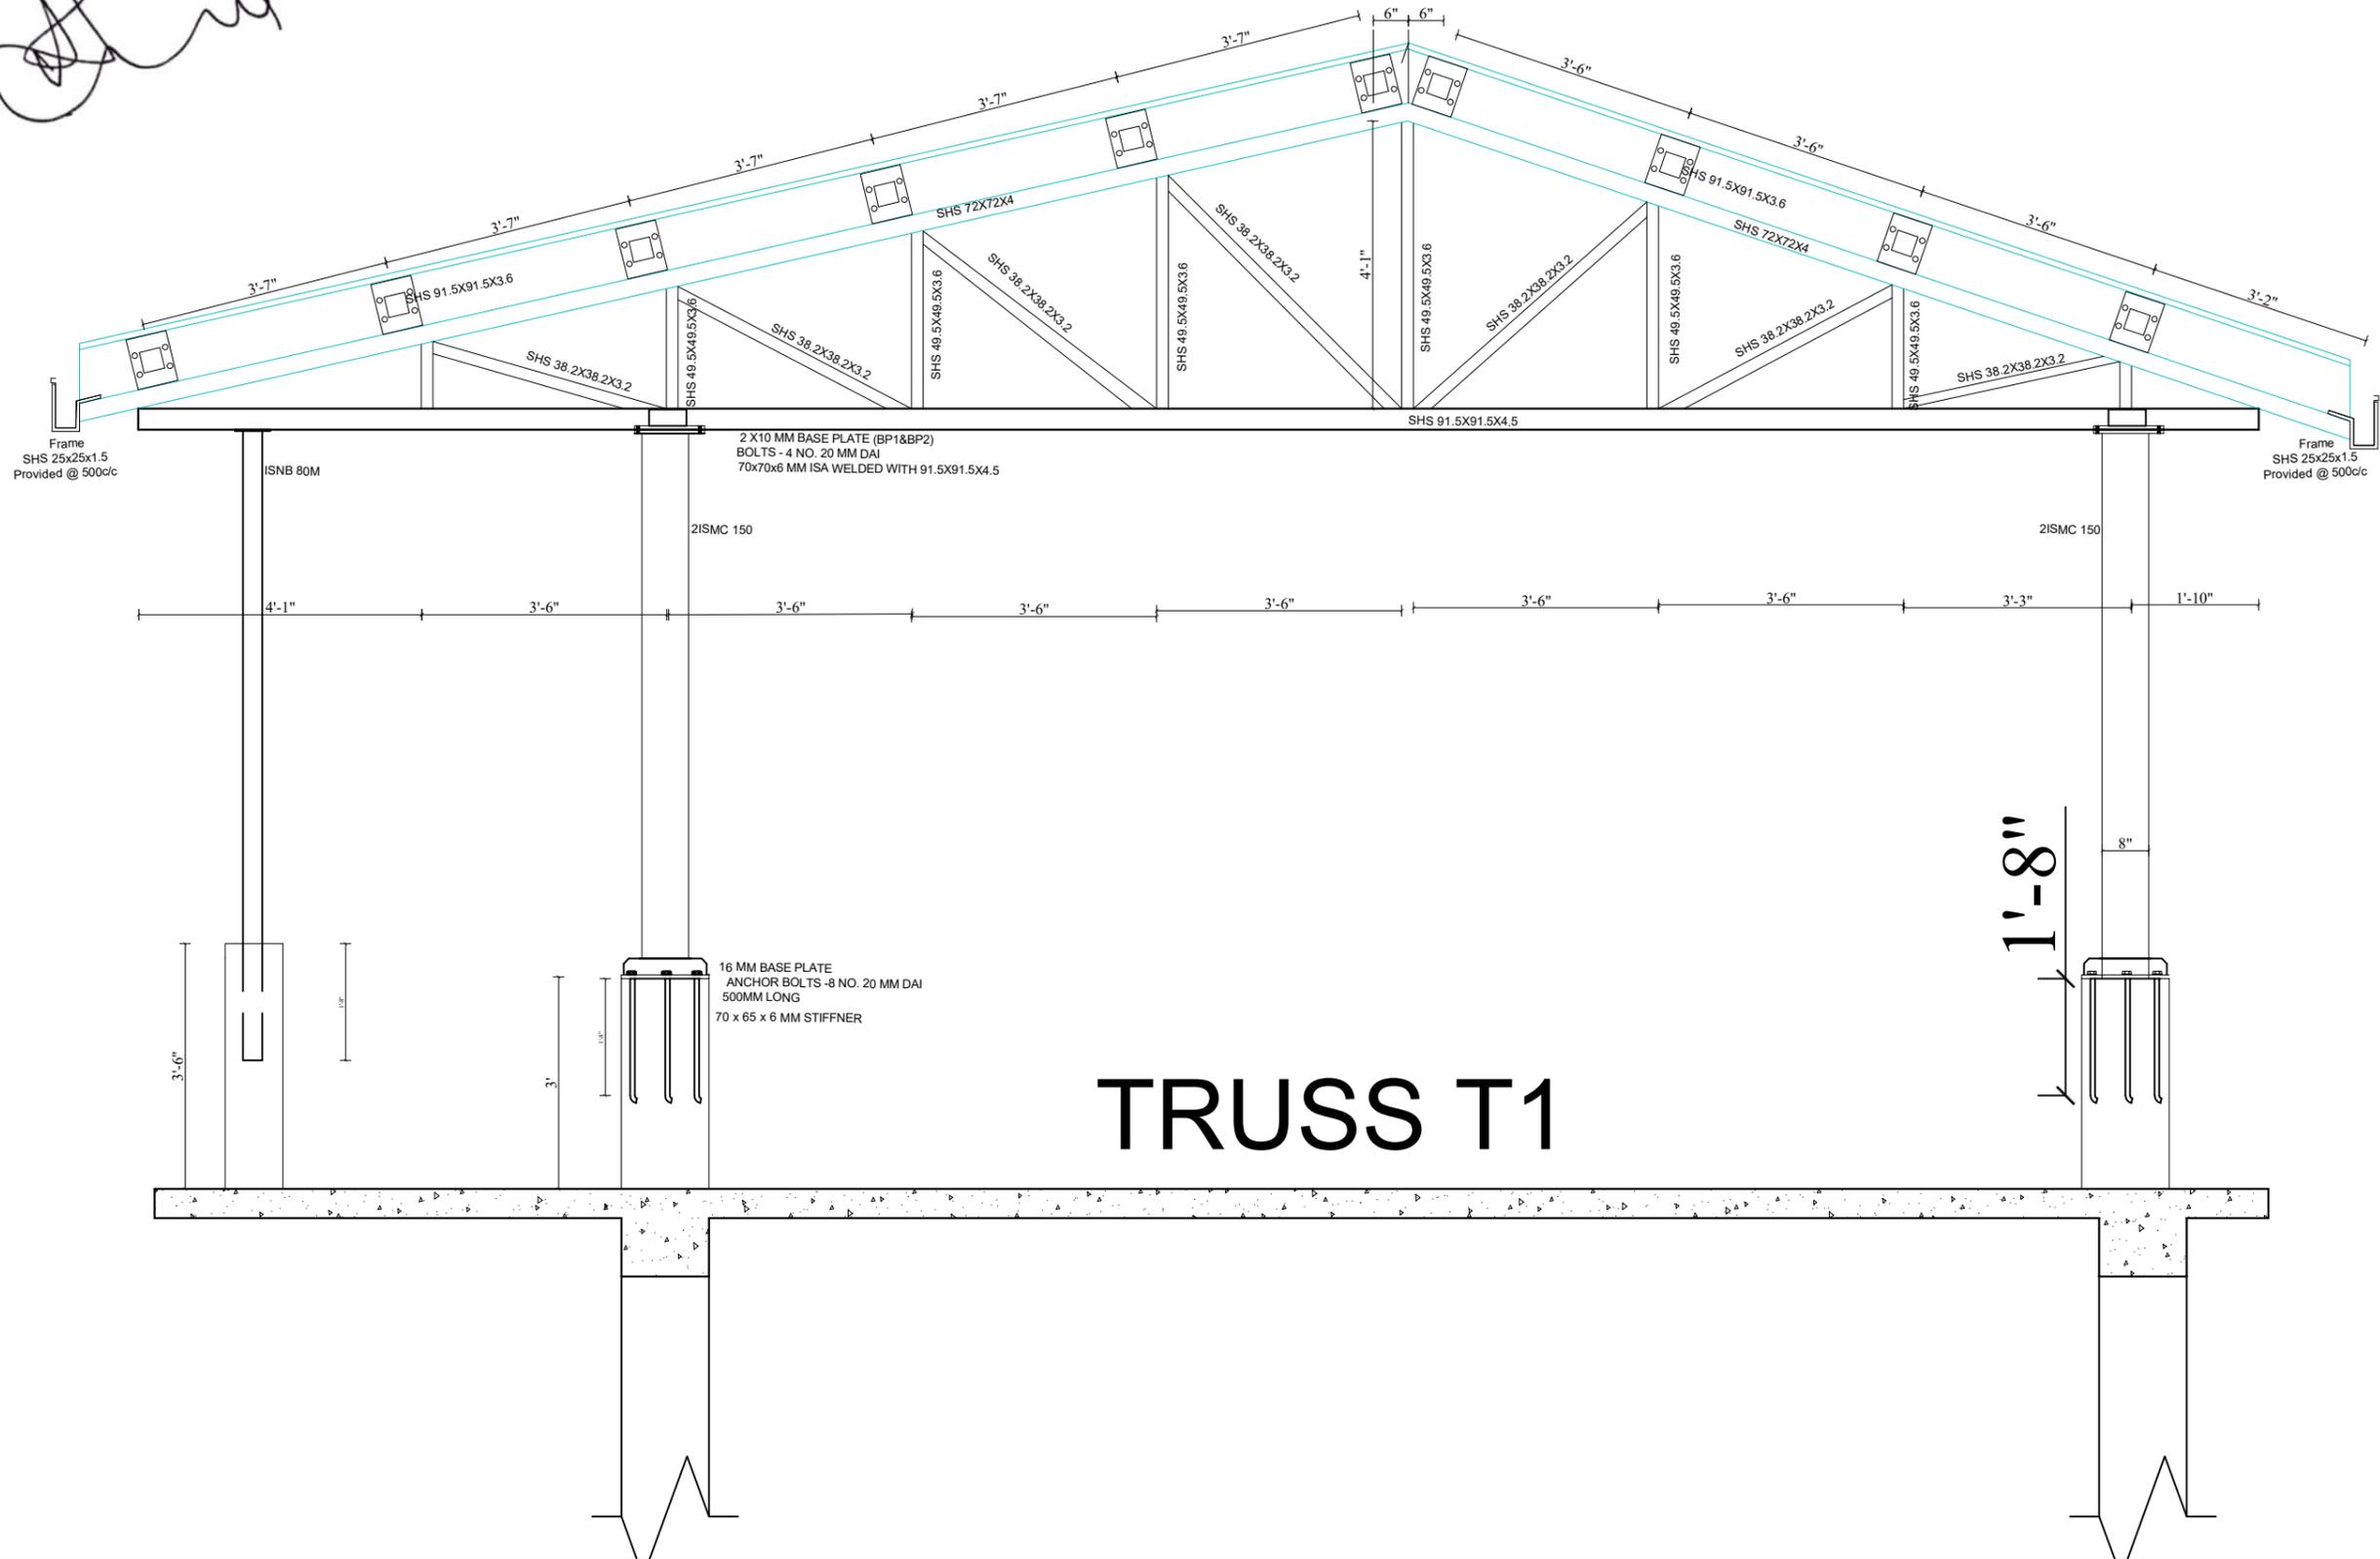

TRUSS T1

<p>INTERFACE ENGINEERING PVT.LTD Koteshwor, Kathmandu info.interfaceng@gmail.com, 01-4544164</p>	<p>PROJECT: Consultancy Service for Construction of Additional one storey Extension with steel structure at KV, EOI, Kathmandu</p>	<p>CLIENT: Kendriya Vidyalaya Embassy of India Lazimpat, Kathmandu, Nepal</p>	<p>APPROVED BY: A. JERALD</p> <p>CHECKED BY:</p>	<p>DESIGNED BY : UMESH THAPA</p> <p>DRAWN BY : ABDUL HAI MIYA</p>	<p>CONSULTANCY STAMP</p>	<p>SHEET TITLE : TRUSS DETAILS T1</p> <p>DATE :DEC, 2025</p> <p>SCALE : 1:50</p>	<p>Sheet no :-</p> <p style="font-size: 2em; border: 2px solid black; border-radius: 50%; padding: 5px; display: inline-block;">4</p>
---	---	--	--	---	--------------------------	---	---

Handwritten signature

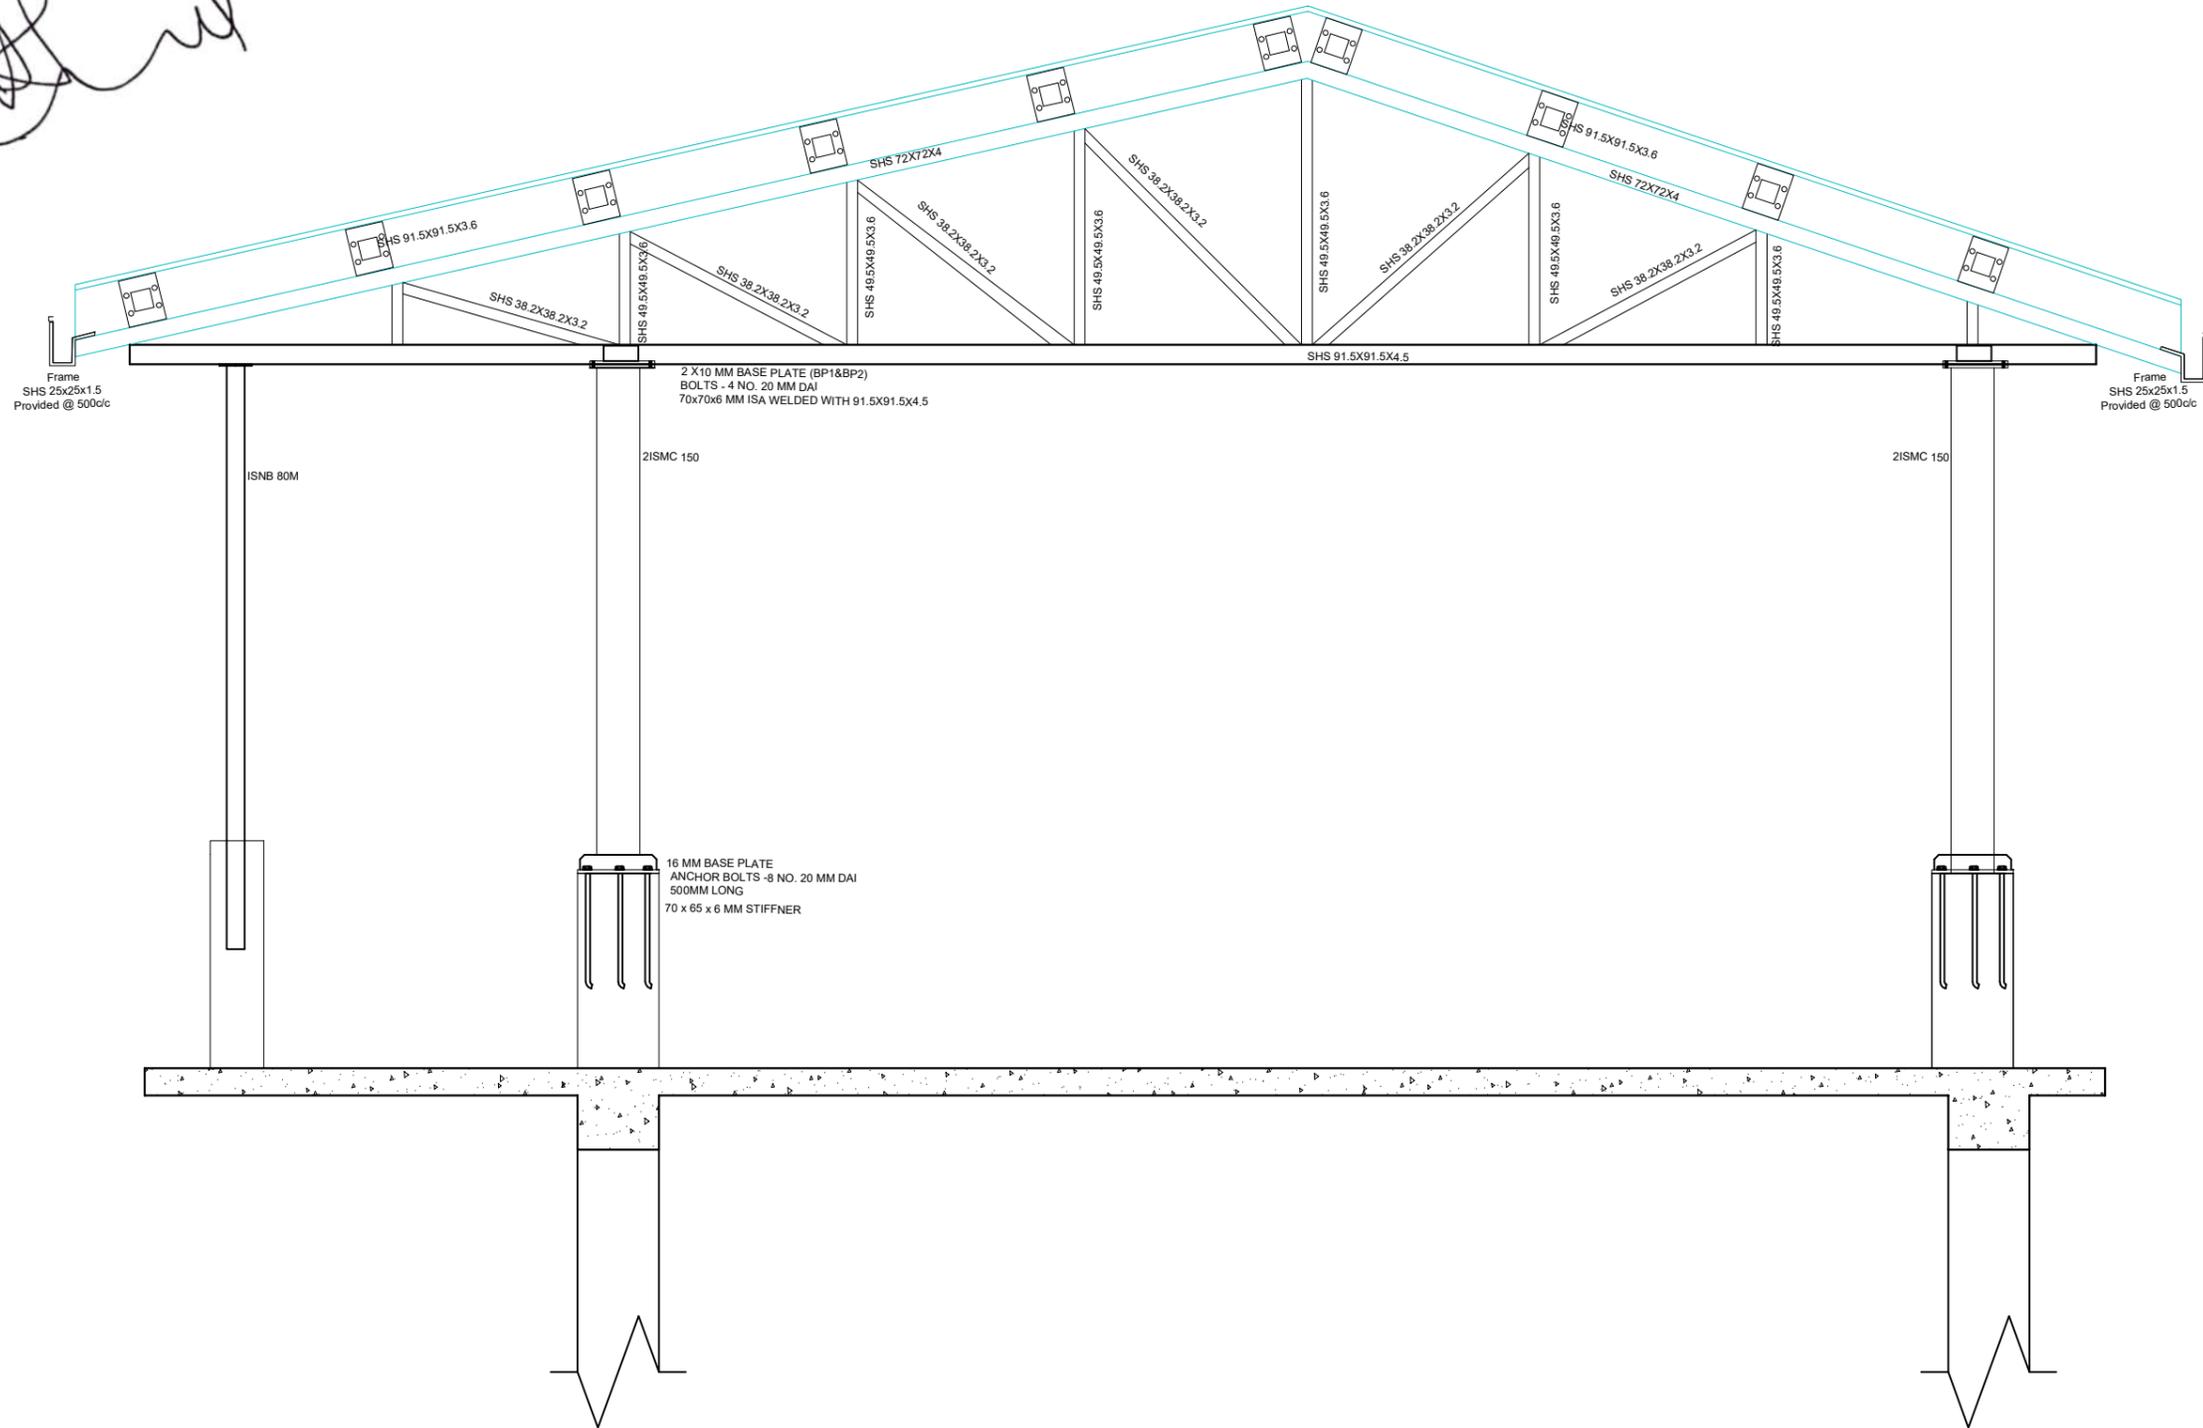


SECTION AT Y-Y

NOT IN SCALE

<p>INTERFACE ENGINEERING PVT.LTD Koteshwor, Kathmandu info.interfaceeng@gmail.com, 01-4544164</p>	<p>PROJECT: Consultancy Service for Construction of Additional one storey Extension with steel structure at KV, EOI, Kathmandu</p>	<p>CLIENT: Kendriya Vidyalaya Embassy of India Lazimpat, Kathmandu, Nepal</p>	<p>APPROVED BY: A. JERALD</p> <p>CHECKED BY:</p>	<p>DESIGNED BY : UMESH THAPA</p> <p>DRAWN BY : ABDUL HAI MIYA</p>	<p>CONSULTANCY STAMP</p>	<p>SHEET TITLE : TRUSS DETAILST1</p> <p>DATE : DEC, 2025</p> <p>SCALE : 1:50</p>	<p>Sheet no :-</p> <p style="font-size: 2em; text-align: center;">5</p>
--	---	--	--	---	---------------------------------	---	---


Handwritten signature

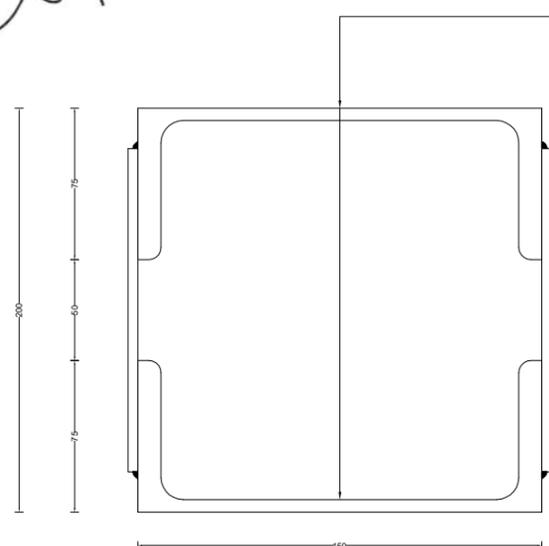

ISMC 150


6 mm thick Batten of size 180x300mm (LxH) connected with channel through 4mm fillet weld and placed at every 500mm C/C spacing throughout the length of column .

**Steel Column
2-ISMC 150**

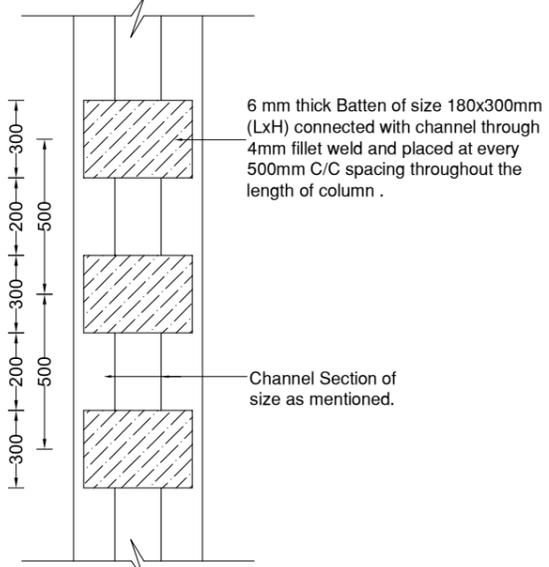


**Typical Column Arrangement
Detail Showing Batten Placement**

NOT IN SCALE

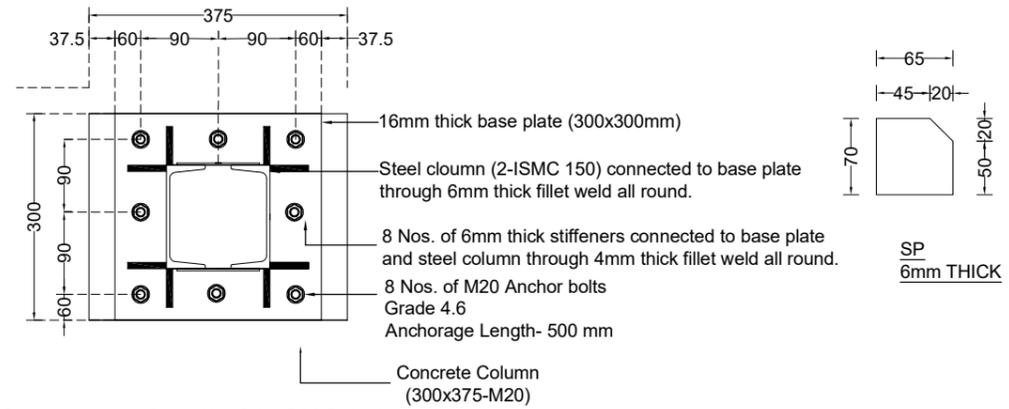

**Connection Detail of 2-ISMC 150 and
Concrete Column (300x375mm)
(Plan)**

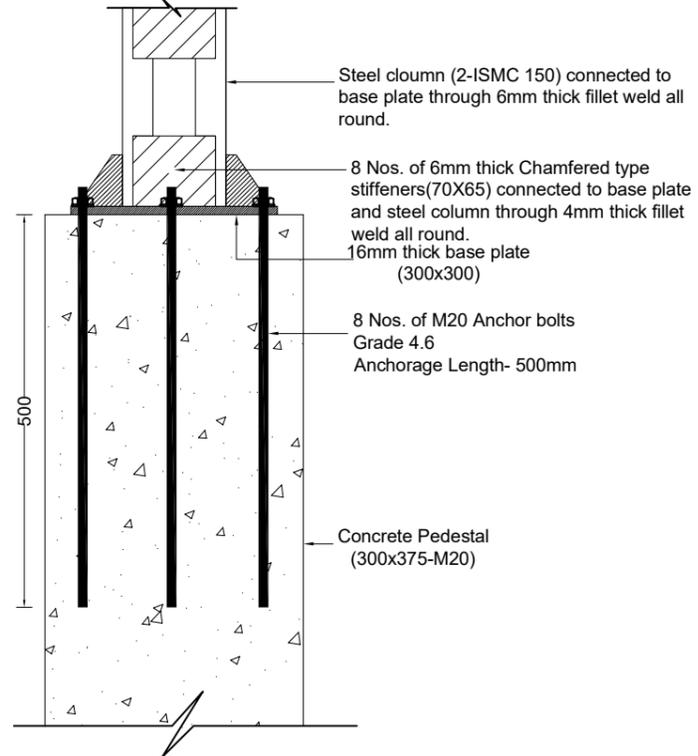

**Connection Detail of 2-ISMC 150 and
Concrete Pedestal (300x375mm)
(Sectional Elevation)**

INTERFACE ENGINEERING PVT.LTD

Koteshwor, Kathmandu
info.interfaceeng@gmail.com, 01-4544164

PROJECT:
Consultancy Service for Construction of
Additional one storey Extension with steel
structure at KV, EOI, Kathmandu

CLIENT:
Kendriya Vidyalaya
Embassy of India
Lazimpat, Kathmandu, Nepal

APPROVED BY:
A. JERALD

CHECKED BY:

DESIGNED BY : UMESH THAPA

DRAWN BY : ABDUL HAI MIYA

CONSULTANCY STAMP

SHEET TITLE :
TRUSS DETAILS T1
DATE :DEC, 2025
SCALE : 1:50

Sheet no :-

7